

F H W A	STATE	FED. AID PROJ. NO	SHEET NO	TOTAL SHEET
REGION NO				
3	MD.		20	25

GENERAL NOTES

1. ALL STRIPING SHOWN IS PROPOSED AND WILL BE INSTALLED BY OTHERS.
2. "D.O" INDICATES DELAY OUTPUT LOOP DETECTOR. SUBJECT TO CHANGE BY THE ENGINEER.
3. REVISION "B" IS A REVISION TO THE TRAFFIC CONTROL SIGNAL BUILT IN SEPTEMBER, 1971 UNDER CONTRACT NO. P-181X-375.

12" SIGNALS 8" SIGNALS

1-4
R
Y
G


5, 6

(R)


(Y)

(G)

NEMA PHASING

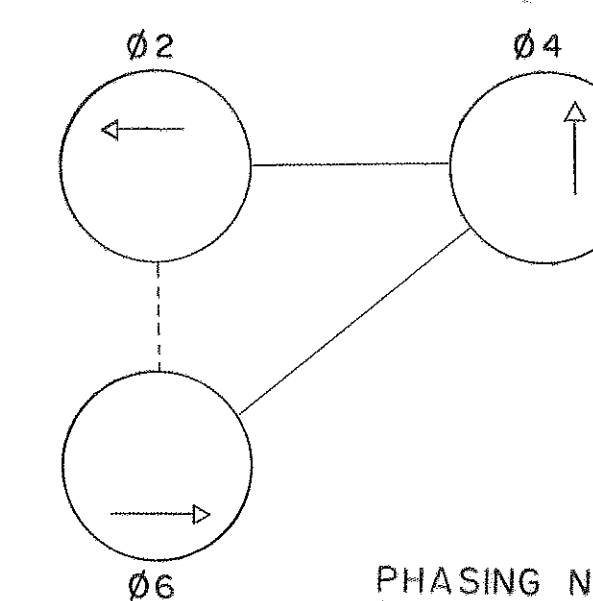


FLASHING OPERATION

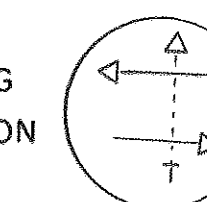

PHASING NOTES

1. PHASES ASSOCIATED BY A SOLID LINE WILL NOT OPERATE CONCURRENTLY.
2. PHASES ASSOCIATED BY A DASHED LINE WILL OPERATE CONCURRENTLY.

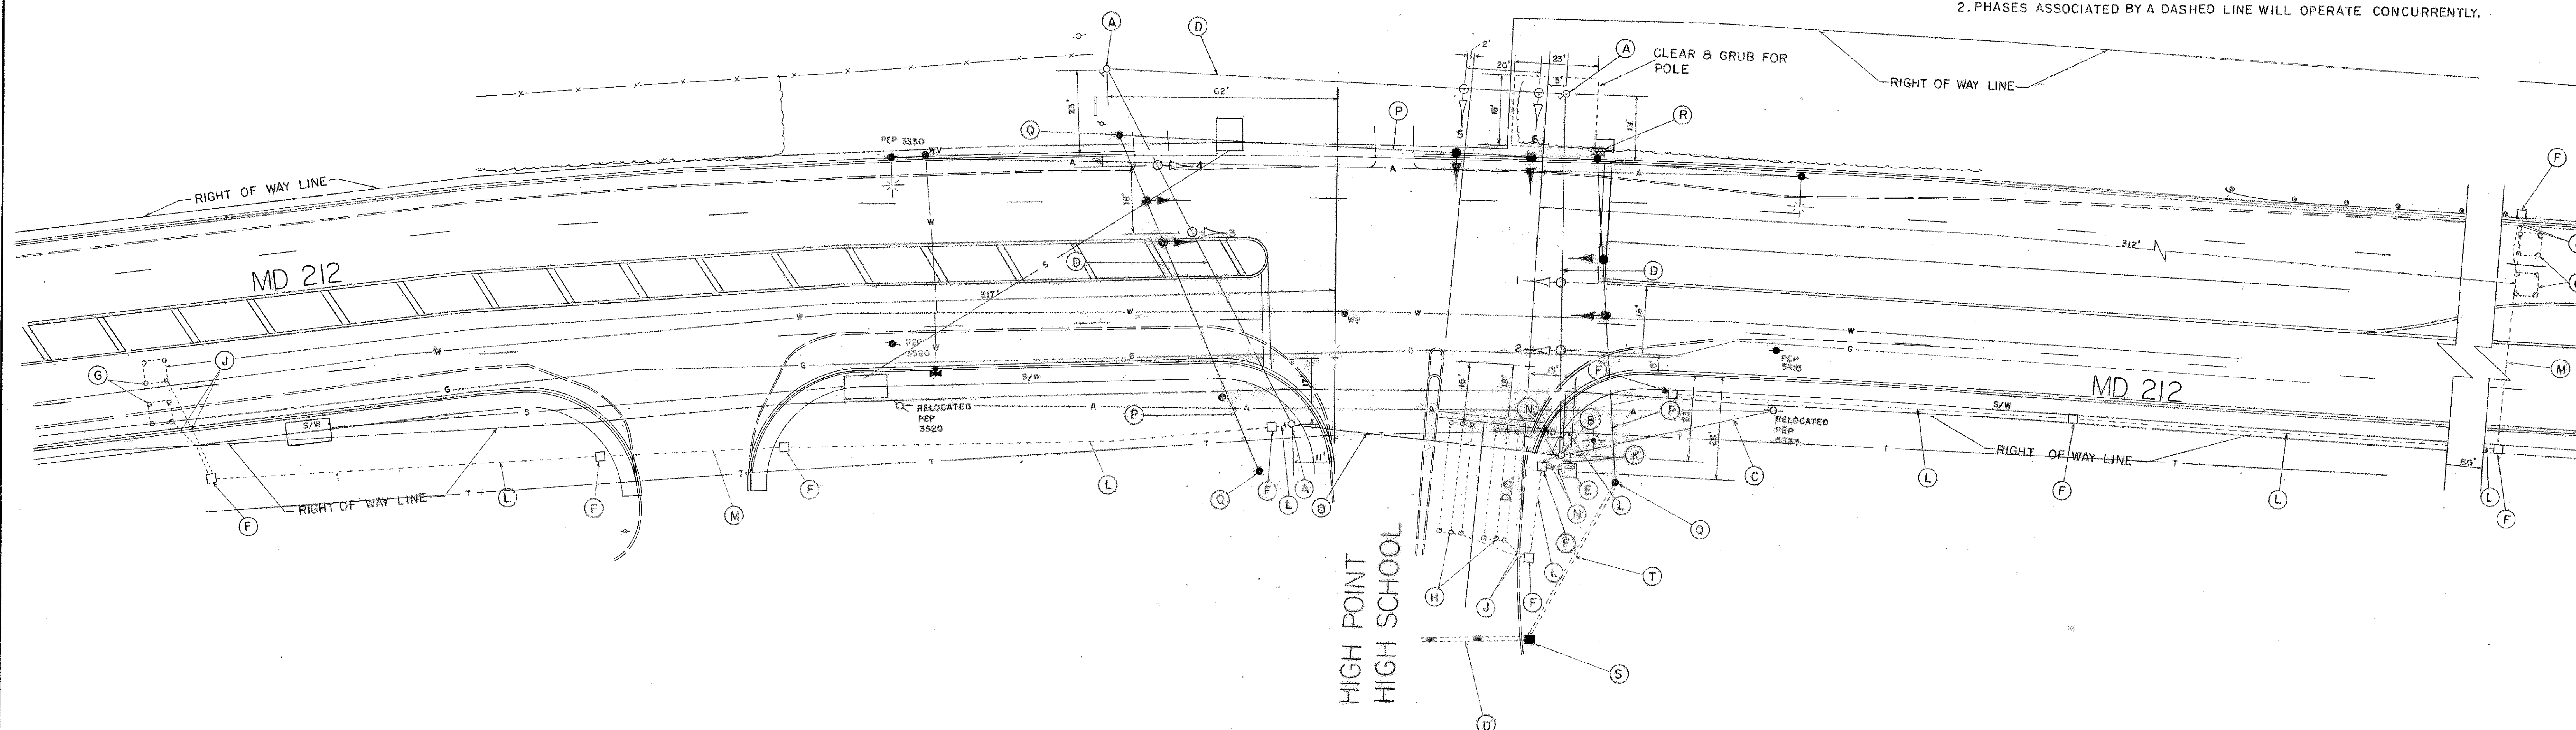

GEOMETRICS LEGEND

EXISTING. _____

PROPOSED _____

LEGEND OF UNDERGROUND AND OVERHEAD UTILITIES

GAS — G — G — G — G — G —

SEWER — S — S — S — S —

WATER — W — W — W — W —

ELECTRIC — E — E — E — E —

CABLE TV — TV — TV — TV — TV —

TELEPHONE — T — T — T — T — T —

AERIAL CABLE — A — A — A — A —

THE TRAFFIC GROUP, INC.

Suite 220, Greenspring Station
2360 W. Joppa Road
Lutherville, Maryland 21093
Telephone 301-583-8405

REVISIONS										APPROVALS									
										<div style="text-align: center;">ORIGINAL ON FILE</div> <div style="display: flex; justify-content: space-between; padding: 5px;"> <div>CHIEF, SIGNAL DESIGN SECTION</div> <div>ASST. DISTRICT ENGINEER, TRAFFIC</div> </div> <div style="display: flex; justify-content: space-between; padding: 5px;"> <div>CHIEF, BUREAU OF TRAFFIC ENGINEERING</div> <div>DEPUTY CHIEF ENGINEER, OFFICE OF TRAFFIC</div> </div>									
B. 8-19-86 REBUILD DUE TO ROAD WIDENING S.H.A. NO. P-858-501-383 G. C. 1010181 1010181 1010181																			
A. 10-17-72																			
ASBUILT																			
JWG					WFF														

MD 212 AND HIGH
POINT HIGH SCHOOL

SIGNAL NO. 16235 COUNTY: PRINCE GEORGES
SCALE: 1"=20' DATE: 1-11-71

MARYLAND DEPARTMENT OF TRANSPORTATION
STATE HIGHWAY ADMINISTRATION - OFFICE OF TRAFFIC
BUREAU OF TRAFFIC ENGINEERING

DRAWN BY H.J. REINHARDT
REDRAWN BY M.M. OF
THE TRAFFIC
GROUP INC. 8/19/86

F.A.P. NO.	N/A
S.H.A. NO.	P-18IX - 375

TS/FILE NO.	178B
-------------	------

DES. BY: H.J. REINHARDT
CHK. BY: J. SPENCE

SHEET NO.

20 OF 25